

Heading:

27/2012/0211/PF

Hen Pandy Barn, Tan y Fron Farm,
Llangollen

4

Graham Boase
Head of Planning & Public Protection
Denbighshire County Council
Caledfryn
Smithfield Road
Denbigh
Denbighshire LL16 3RJ

 Application Site



Date 3/7/2012

Scale 1/2500

Centre = 320513 E 345697 N

This plan is intended solely to give an indication of the LOCATION of the application site which forms the subject of the accompanying report. It does not form any part of the application documents, and should not be taken as representative of the proposals to be considered, which are available for inspection prior to the meeting.





This map is reproduced from Ordnance Survey material with the permission of Ordnance Survey on behalf of the Controller of Her Majesty's Stationery Office. © Crown copyright. Unauthorized reproduction infringes Crown copyright and may lead to prosecution or civil proceedings. Denbighshire County Council. 100023408. 2011.

Atgynhychir y map hwn o ddeunydd yr Ordnance Survey gyda chariatâd yr Ordnance Survey ar ran Rheolwr Llyfrfa Ei Mawrhydi © Hawffraint y Goron. Mae atgynhychu heb ganiatâd yn torri hawffraint y Goron a gall hyn arwain at erlyniad neu achos sifil. Cyngor Sir Ddinbych. 100023408. 2011.

27/2/2012 10:11:11 P.F

Construction Drawings and Planning Regulations
 This drawing is a preliminary design and is not to be used for construction purposes. It is subject to the approval of the relevant authorities. The client is responsible for ensuring that the drawing is used for the intended purpose and that all necessary permissions are obtained. The drawing is not to be used for any other purpose without the written consent of the author.

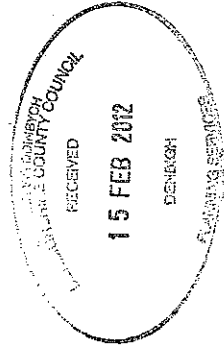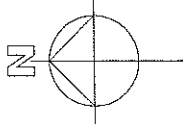

No.	Description	FOR APPROVAL FOR CONSTRUCTION	FOR TENDER AS BUILT	DATE	BY	CLASS
A	Notes for all construction drawings.	<input type="checkbox"/>	<input type="checkbox"/>			




lawray architects
 pensein

Office: 10, The Business Village,
 10, The Business Village,
 Tel: 01794 521111
 Fax: 01794 521112
 www.lawray.co.uk
 e: info@lawray.co.uk
 Also at Cardiff and London

SITE PLAN

CLIENT	MR & MRS T RHYS HUGHES
PROJECT	HEN PANDY BARN EXTENSIONS & ALTERATIONS
DRAWING TITLE	PROPOSED SITE PLAN
DATE	11.11
SCALE	AS SHOWN
NO. DRAWING NO.	DI
REV.	
NO. DRAWING NO.	N1436
PROJECT NO.	PR.01
REV.	A


Copyright LAWRAY LIMITED.
 Any disclosure or reuse of information contained in this drawing is strictly prohibited without the author's consent.

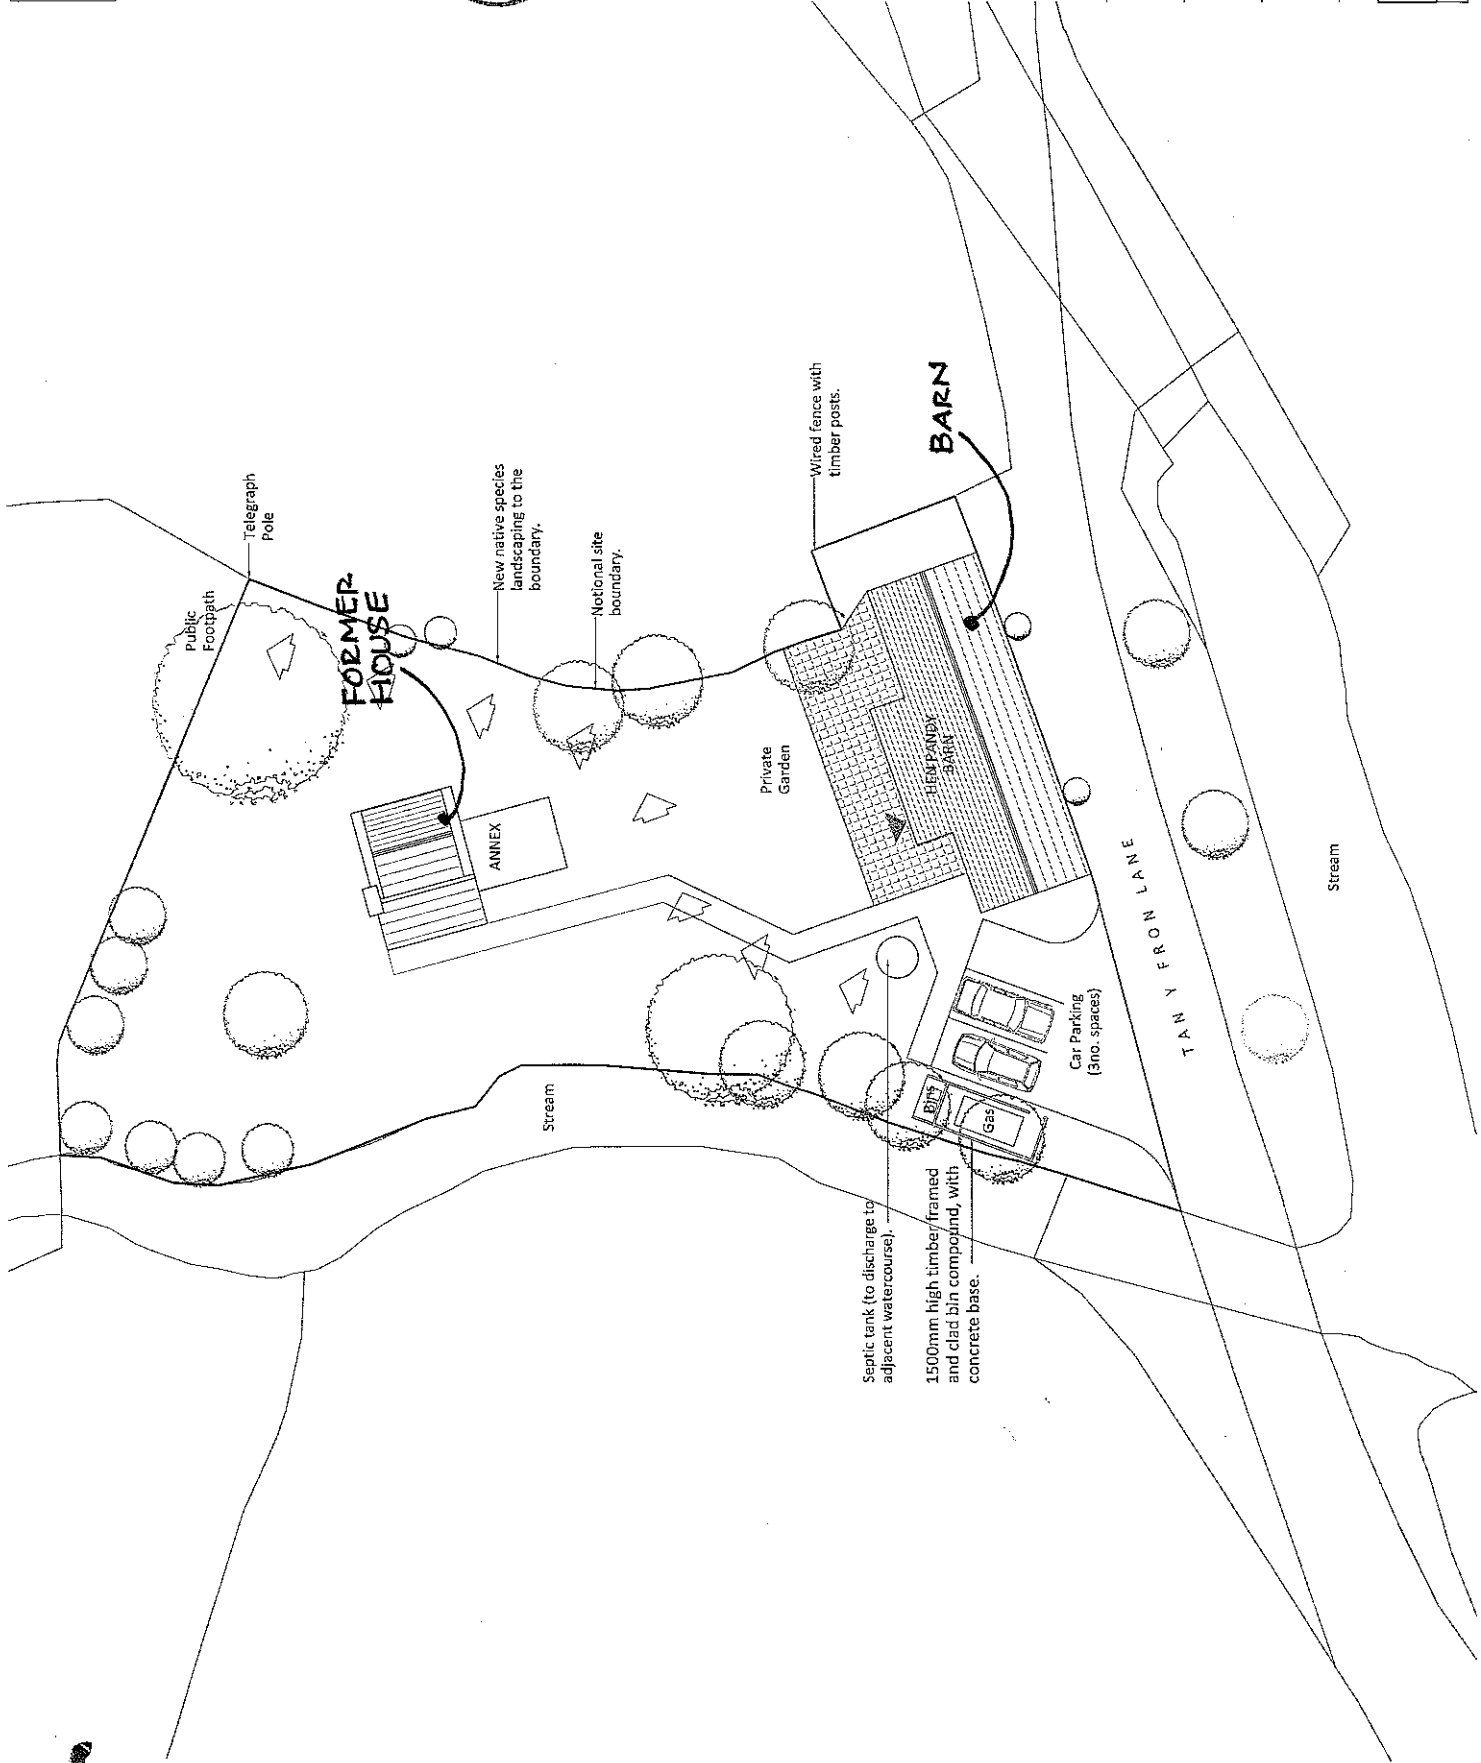

Construction Design and Management/Regulation
 Design submissions are prepared through the design stage of all projects. In accordance with the Building Regulations, the design team must submit a full set of drawings and specifications for the proposed work. The design team must also submit a full set of drawings and specifications for the proposed work. The design team must also submit a full set of drawings and specifications for the proposed work. The design team must also submit a full set of drawings and specifications for the proposed work.

Materials:

- Walls: Natural random rubble stone & paint finished render.
- Roof: Selected second hand natural slate with matching ridge tiles.
- Windows: Stained double glazed timber window units and rooflights.
- Doors: Stained timber doorsets.
- Rainwater Goods: Black UPVC downpipes and gutters.

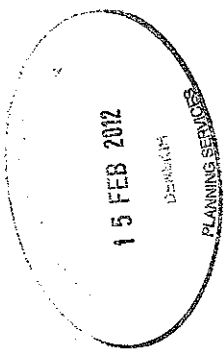

Received following comments from Planning Authority
 Rev Description Date By Clerk
 FOR APPROVAL FOR CONSTRUCTION AS BUILT




lawray architects


Popple House, Vyle Industrial Village,
 Wrexham, LL13 7YL
 Tel: 01978 230204
 wrexham@lawray.co.uk
 enquiries@lawray.co.uk
 Also in Chertsey and London

PROPOSALS FOR BARN


OWNER	MR & MRS T RHYS HUGHES
ARCHITECT	HEN PANDY BARN EXTENSIONS & ALTERATIONS
DESCRIPTION/TITLE	PROPOSED PLAN & ELEVATIONS TO BARN
DATE	11.11
SCALE	1:50
DRAWN	DI
CHECKED	
PROJECT NO.	N1436
REF	PR.02
DATE	15.03.12
PROJECT	Copyright LAWRA Y ARCHITECTS

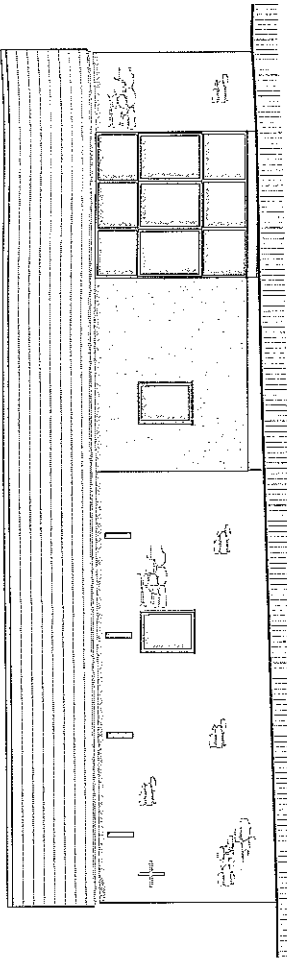


FRONT ELEVATION (SOUTH)

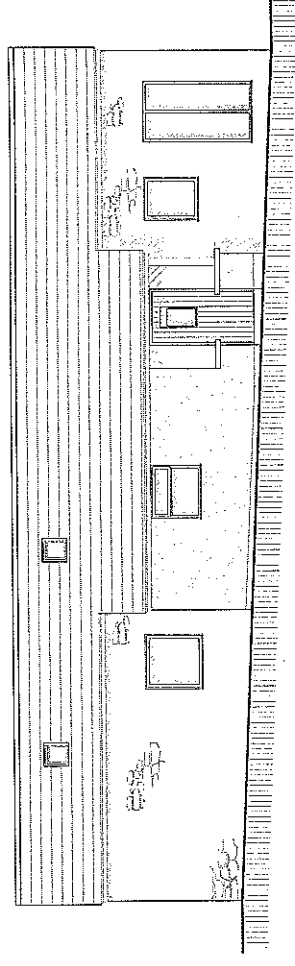


REAR ELEVATION (NORTH)

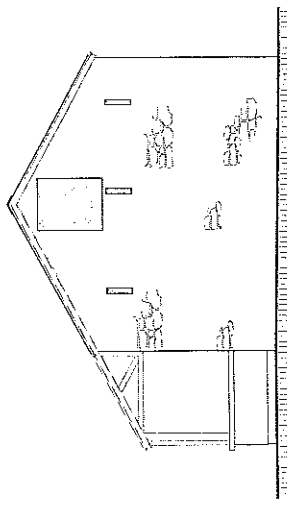


SIDE ELEVATION (WEST)

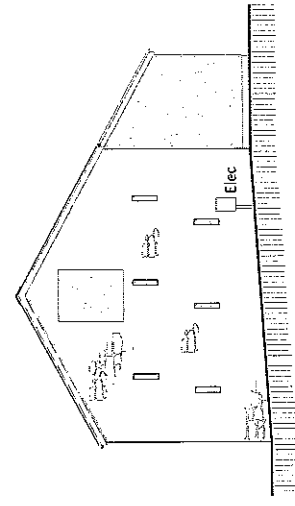

SIDE ELEVATION (EAST)

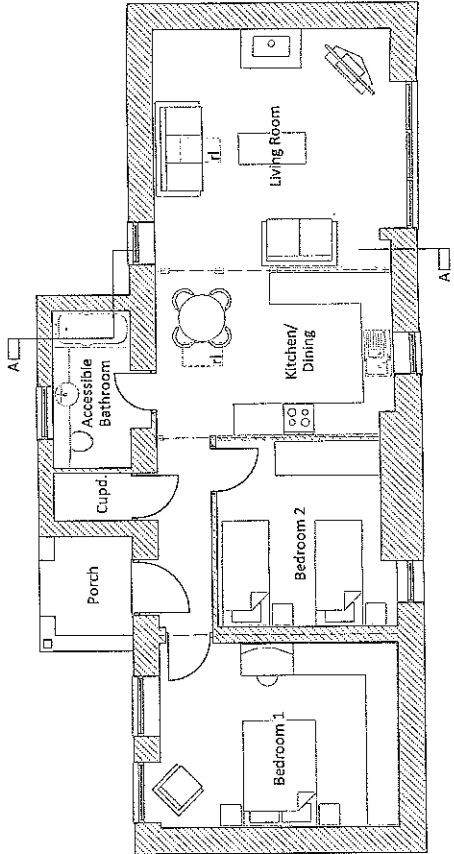

PLAN

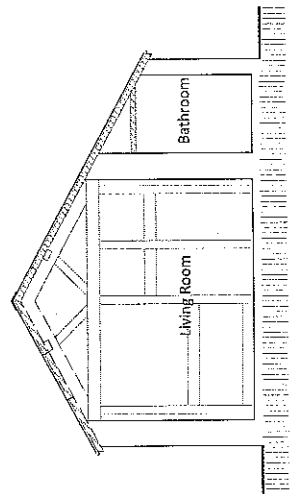

SECTION A-A

